


Figure 3 - Site Plan/As-built Drawing

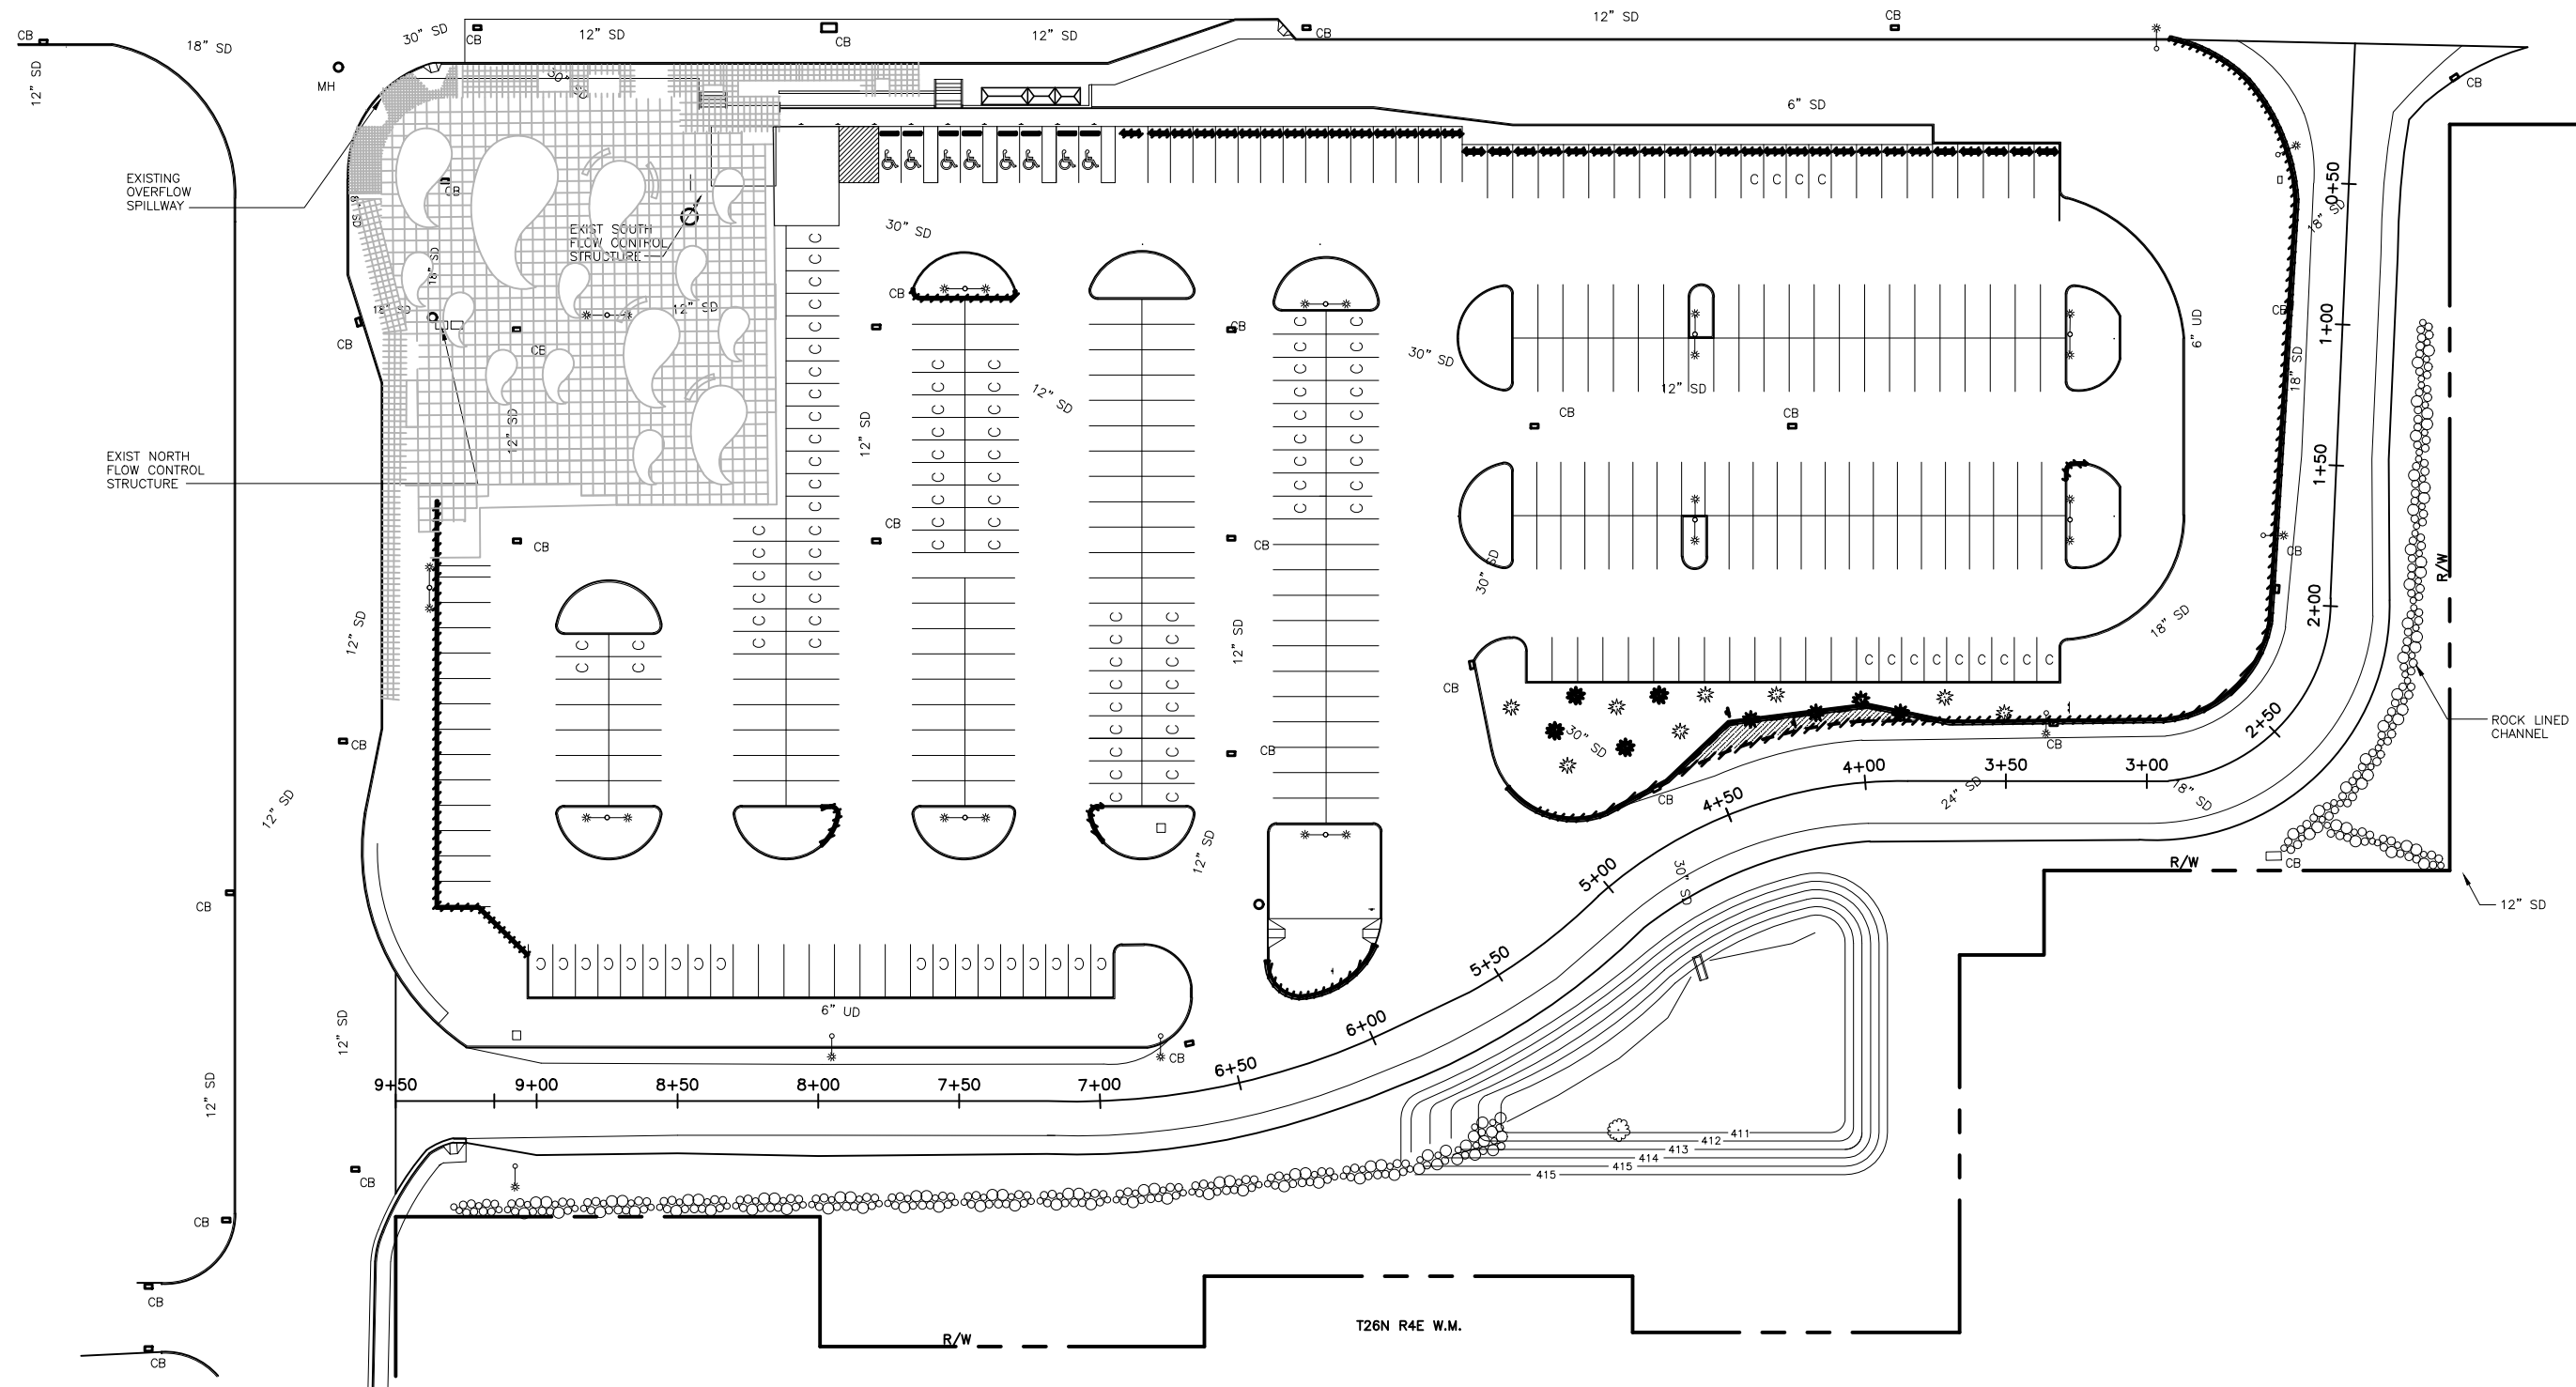


No.	REVISION	BY	APP'D	DATE

PAVING PROGRAM
INSPECTION AND REPAIR
DRAWING

Call
before you
Dig.
1-800-424-5555
UNDERGROUND SERVICE (USA)
Exhibit 3-p1

DESIGNED: DRAWN: CHECKED: RECOMMENDED:	PROJECT MANAGER: M. LAWSON APPROVED: L. MORTENSEN IBIS NO: WORK REQUEST: CONTRACT NO:	SCALE: AS NOTED SITE LOCATION NO: ONE INCH AT FULL SIZE 1" IF NOT ONE INCH, SCALE ACCORDINGLY
---	---	--

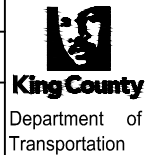

METRO TRANSIT DIVISION
INSPECTION DRAWING
SHORELINE

DATE: 4/7/2016
DRAWING NO: 1
SHEET NO: OF 1